
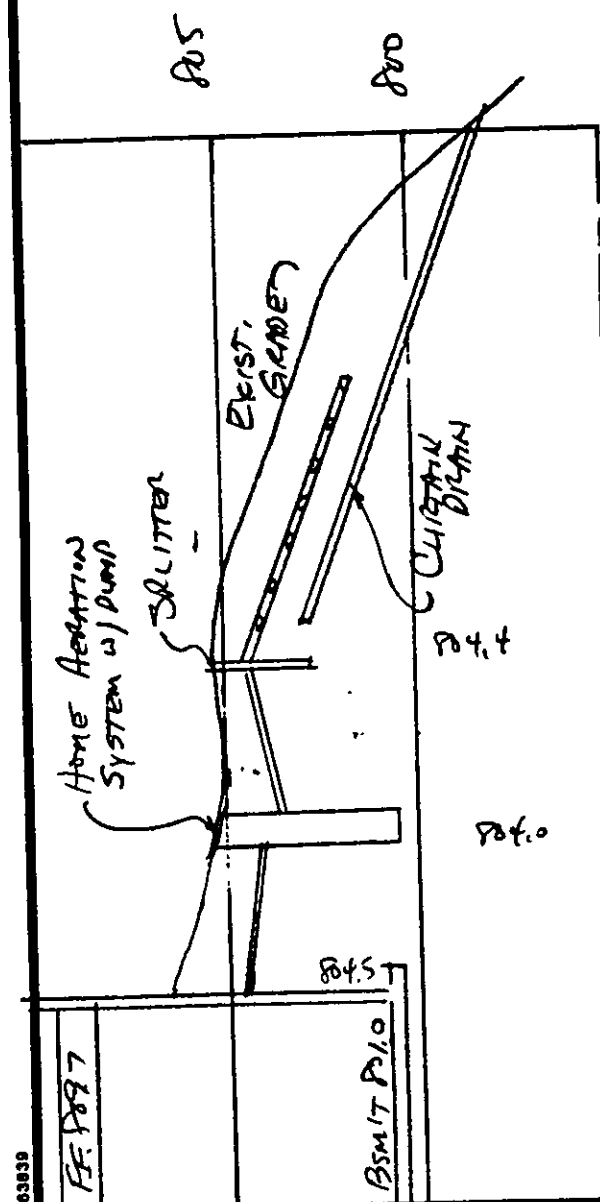


REVIEWED AND ACCEPTED  
LAKE COUNTY GENERAL  
HEALTH DISTRICT

Date 5/23/97 BY Harry S. Jones, Jr.

SEWAGE DISPOSAL PERMIT MUST BE  
OBTAINED BY A LAKE COUNTY LICENSED  
INSTALLER BEFORE INSTALLATION IS  
STARTED


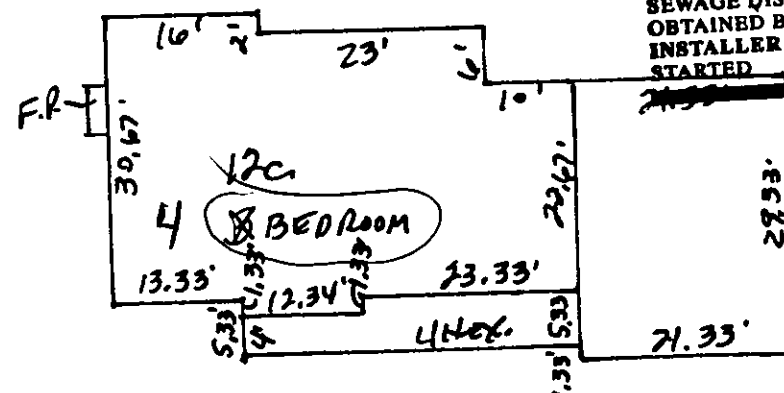


HYDRAULIC PROFILE  
HORIZ: 1" = 40' VERT: 1" = 5'

Grading Plan Approved  
as shown and/or noted  
THOMAS P. GILES, P.E.  
Lake County Engineer

By TAM Date 5/13/98  
12" DRAIN CULVERT  
LOWER FINISH GRADE ON NORTH  
SIDE TO 805.5

ROOF DRAINS  
SHALL DISCHARGE  
TO SPLASH BLOCKS.

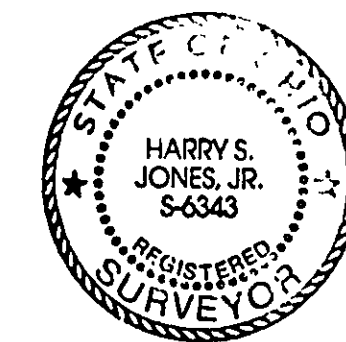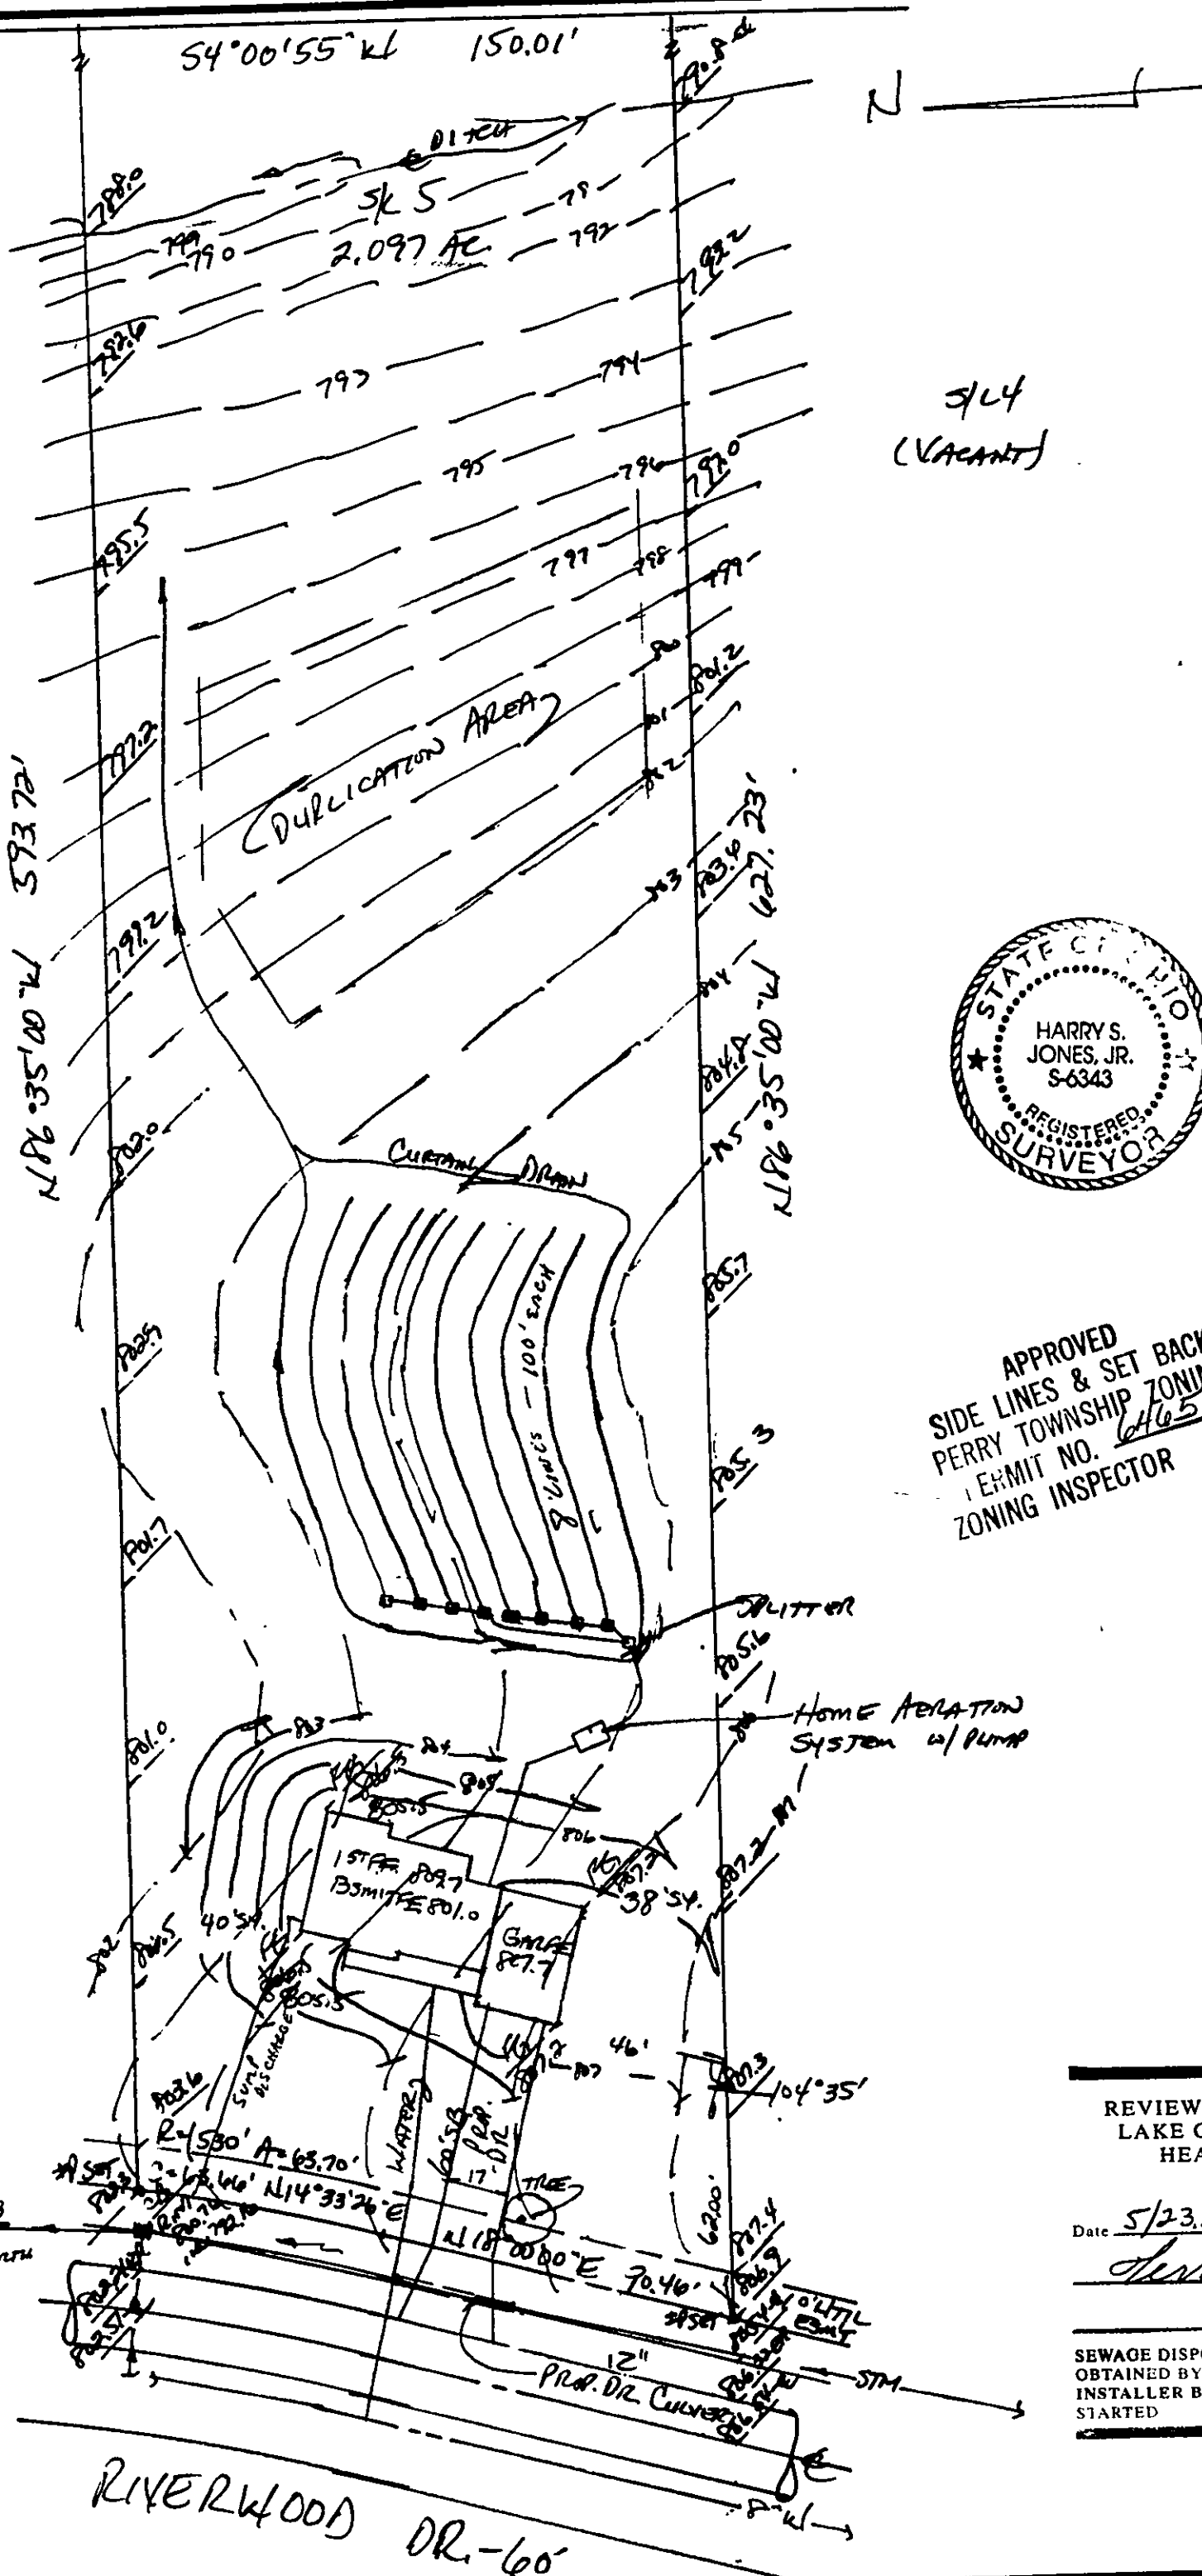

APPROVED  
SIDE LINES & SET BACK  
PERRY TOWNSHIP ZONING  
PERMIT NO. 6465  
ZONING INSPECTOR

# **SITE PLAN**

PERRY TOWNSHIP, LAKE COUNTY, OHIO

for: OMAHEN CONSTRUCTION

ADDRESS	STREET	CITY	ZIP
RIVERWOOD SUB.	STREET	CITY	ZIP
SUBDIVISION	NAME	LOT	TRACT
5	27-28	VOLUME	PAGE
SUBLOT NO.	STREET	PERM. PARCEL NO.	STREET

## **LEGEND**

SANITARY MANHOLE	---	WATER VALVE (GAS)	---
STORM MANHOLE	---	WATER METER (GAS)	---
INLET OR CATCH BASIN	---	AS BUILT ELEVATION	---
HYDRANT	---	INDICATES DIRECTION OF SURFACE DRAINAGE	---
EXISTING CONTOURS	---		
PROPOSED CONTOURS	---		
EXIST. ELEV.	---		
100.0			
100.0			
PROP. ELEV.			

## **REMARKS**

ALL BOUNDARY DATA SHOWN WAS OBTAINED FROM (DEEDS, RECORDED  
SUBDIVISION PLAT OR OTHER PUBLIC RECORDS)

LOCATIONS AS SHOWN OF ADJACENT WELLS AND SEPTIC TANKS OBTAINED FROM  
LAKE COUNTY HEALTH DEPARTMENT

## **DESIGN CERTIFICATION**

THIS PLAT WAS PREPARED BY ME, AND IS CORRECT  
TO THE BEST OF MY KNOWLEDGE AND BELIEF.

NAME Harry S. Jones, Jr. SURVEYOR REGISTRATION NO. 6343

## **CHECK LIST**

NO. OF BEDROOMS	WATER MAIN SIZE, LOCATION
DIMENSIONS	SAN. SEWER SIZE % GR. LOC.
BEARINGS	SAN. MH. CAST. ELEV. INV. ELEV.
TIE TO NEAREST STREET	SAN. CONN. SIZE, LOC. DEPTH
SUBLOT NO. PARCEL NO.	STORM SEWER SIZE % GR. LOC.
SURROUNDING OWNERS	STORM MH. CAST. ELEV. INV. ELEV.
BLDG. DIMENSIONS FIN. GR.	PAV'T TYPE GRADE CURBS
BLDG. TIES FL'R. GRADES	GAS LINE LOC. SIZE PRESSURE
APRON TYPE WIDTH THICKNESS	SEPTIC TANK LOCATION & DUPLICATION AREA
SIDEWALK TYPE WIDTH THICKNESS	WELL LOCATION
CULVERT TYPE DIA. LENGTH	ISOLATION RADIUS FROM WELL
ROCK OUTCROPPINGS	

REVISIONS			PLAN PREPARED BY:		
NO.	DATE	BY	BABCOCK • JONES & ASSOCIATES, INC.		
1	4/14/97	HT	PAINESVILLE, OHIO		
2					
3			DRAWN BY	SCALE	PHONE NO.
4			CHK'D.	DATE	357-1811
5			CREW	APPD.	DRAWING NO.
6			CHIEF		96-272-5

## **"AS BUILT" CERTIFICATION**

I, HEREBY CERTIFY THAT THE CIRCLED GRADES ARE EXISTING  
FINISH GRADES CHECKED IN THE FIELD ON \_\_\_\_\_, 19\_\_\_\_  
AND ARE CORRECT TO THE BEST OF MY KNOWLEDGE AND BELIEF.

REGISTERED SURVEYOR REG. NO.

TBM - RIM CATCH BASIN  
ELEV. = 800.96

REVIEWED AND ACCEPTED  
LAKE COUNTY GENERAL  
HEALTH DISTRICT

Date 5/23/97 BY Harry S. Jones, Jr.

SEWAGE DISPOSAL PERMIT MUST BE  
OBTAINED BY A LAKE COUNTY LICENSED  
INSTALLER BEFORE INSTALLATION IS  
STARTED

"I, the undersigned hereby certify that  
this topography, indicated by 6", 1" or 2"  
contours, and elevations shown hereon  
represent an actual field survey made by  
me on the 10th day of MARCH, 1997  
and that the elevations were taken at  
appropriate intervals and that as of that  
date they existed as indicated hereon."

Name Harry S. Jones, Jr. Reg. No. 6343